





9 Concrete to Playground surfacing scale: 1" = 1'-0"

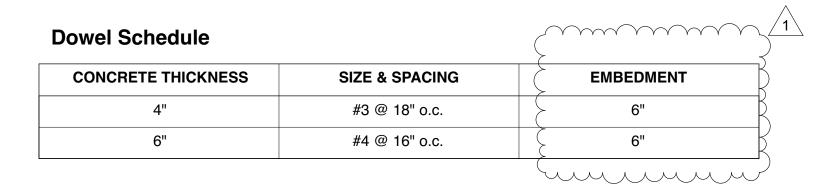

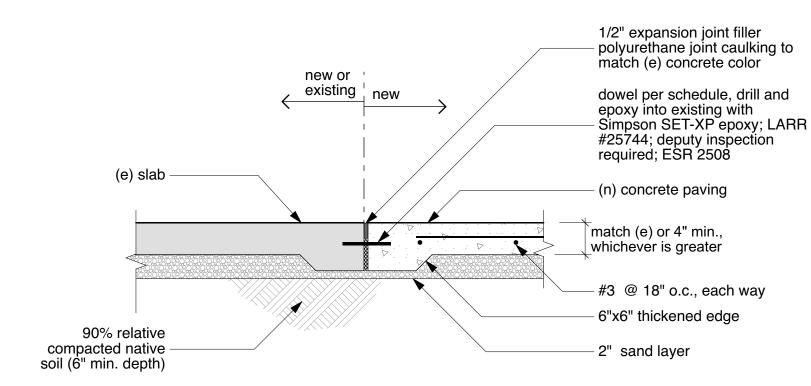


8 Expansion Joint scale: 1" = 1'-0"

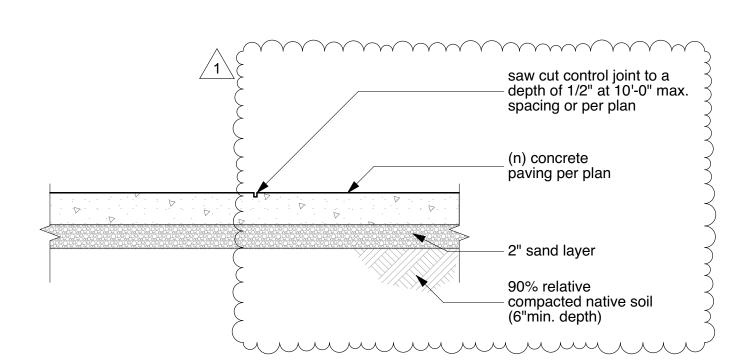

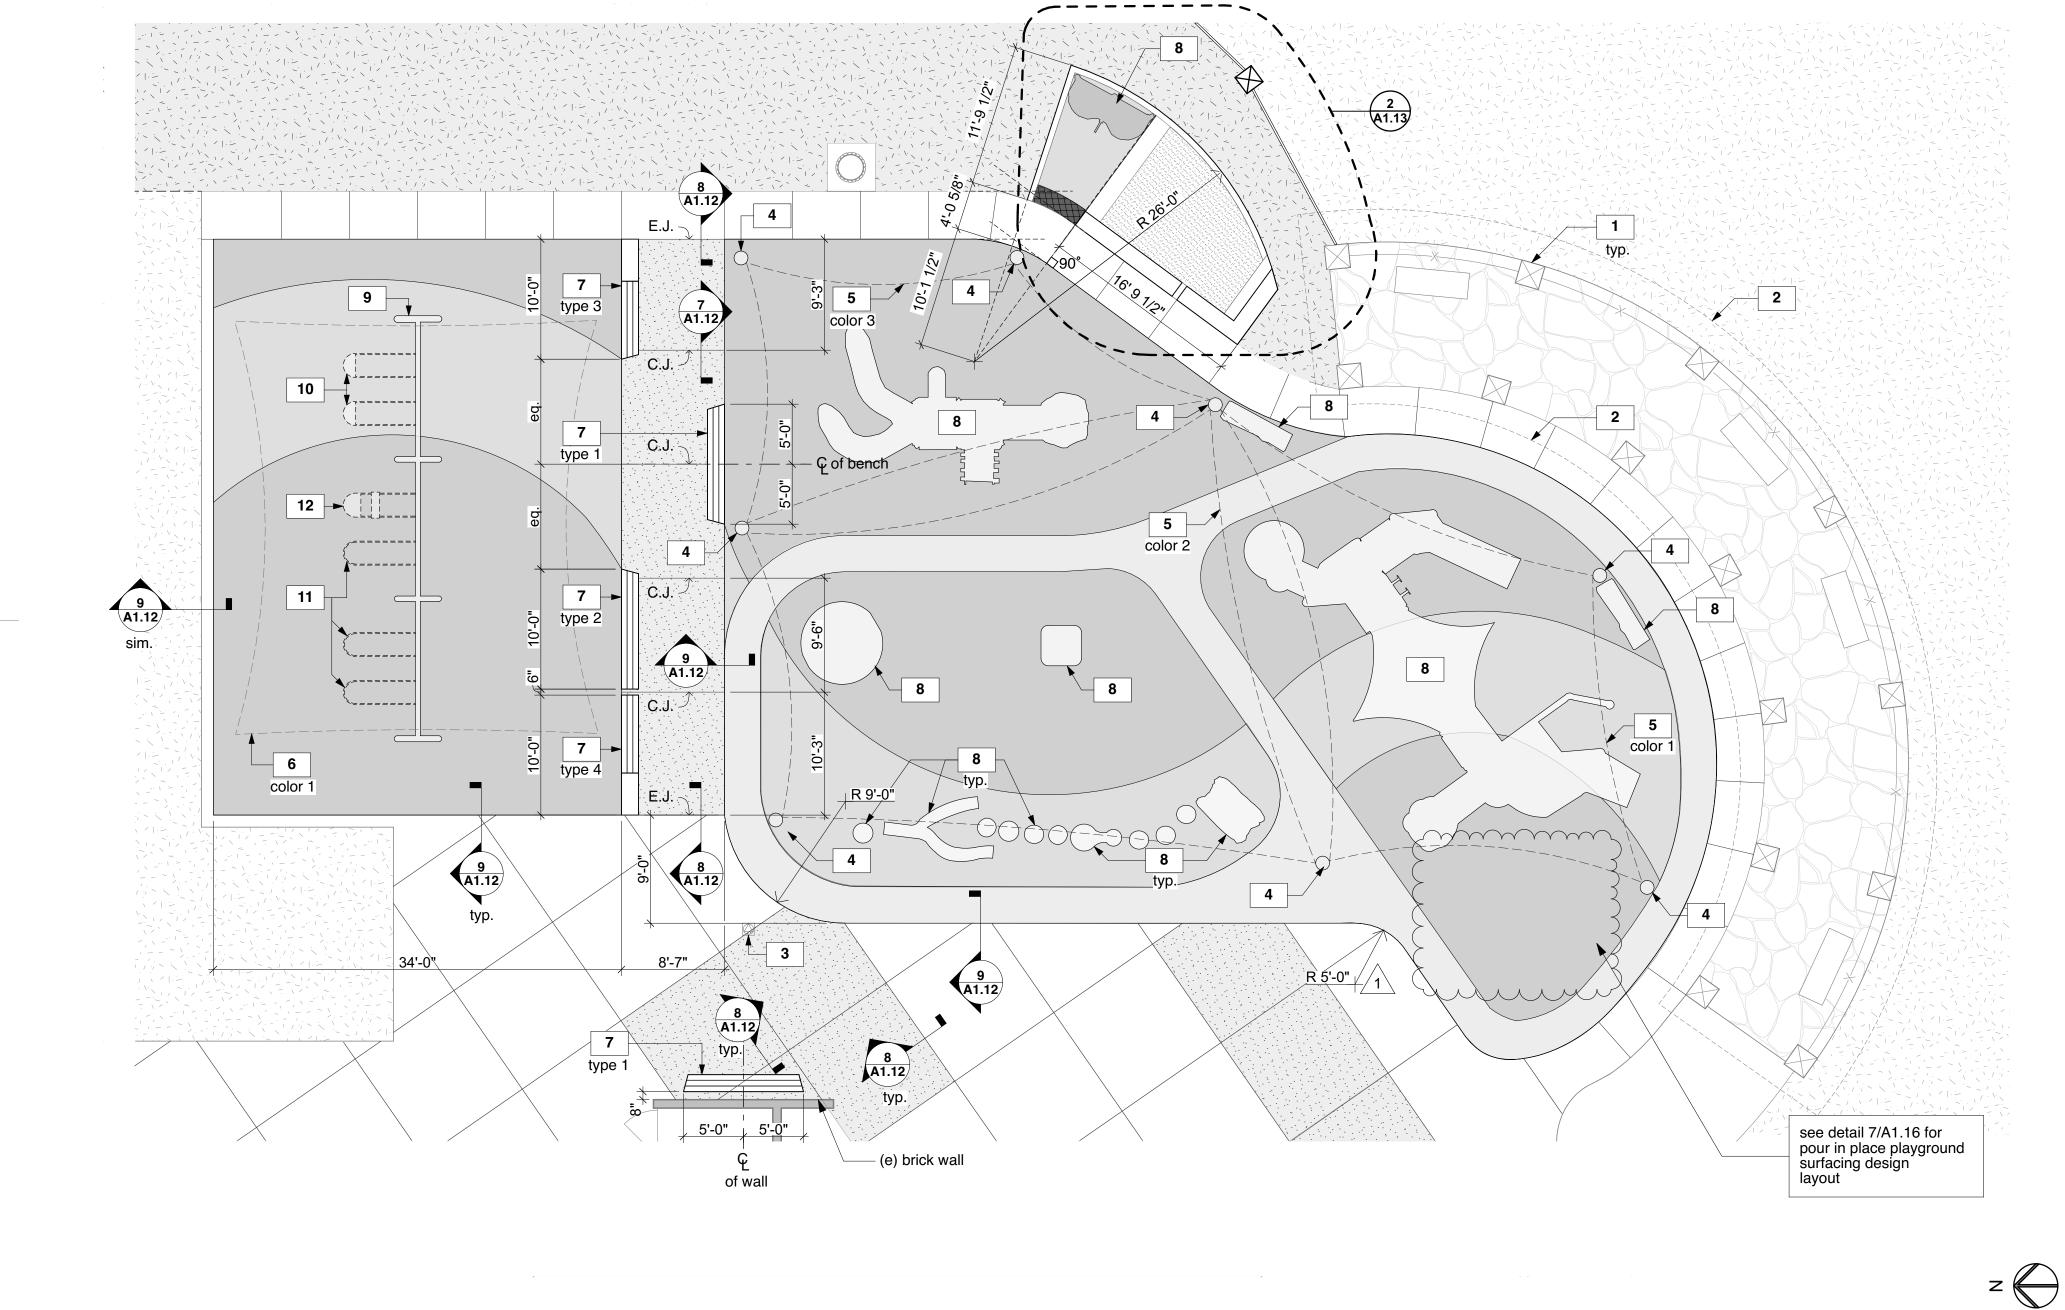

Enlarged Site Plan at Playground

scale: 1/8" = 1'-0"

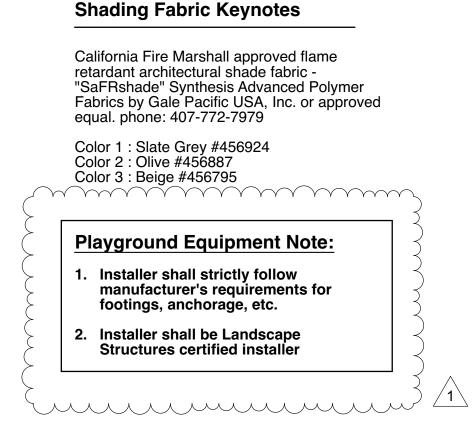

(e) Pergola post, typ. 2 Extent of (e) pergola treflis above (e) Catch basin to remain, see Civil drawings New hypar shade support post - shade sail, post and footings under deferred submittal by Contractor. Specified equip. is Skyways by Landscape Structures or approved equal. Contact Scott Anderson. phone: 818-735-3838 email: scott@recwest.com Extent of new hypar shade sail above. See shade fabric info, this page. Extent of shade above - integral to swing equipment. See shade fabric info, this page. Concrete bench with Resysta top. See enlarged plans on A1.13 New playground equipment is by Landscape Structures, Inc. quote # 104668-1-11. Contact Scott Anderson, phone: 818-735-3838 email: scott@recwest.com Equipment installer to be a Landscape Structures certified Installer. see Drawing Sheets: 104668-1-11 and 104668-1-11F 3-Bay swings with integrated Skyways shade approx. 30' x 35' - 4 columns +H DPE top model

Enlarged Site Plan Keynotes

Belt seat by Landscape Structures, Quote #104668-1-11. Contact Scott Anderson. phone: 818-735-3838 email: scott@recwest.com

Contractor to supply and install new Expression Swing by GameTime Model 5145 - 5" o.d. x 8' top rail on Landscape Structures 3-bay swings. Contact: Nate Younker. Great Western phone: 858-344-0445 email: nate@gwpark.com

Enlarged Site Plan Legend

existing turf existing concrete paving new or replaced turf - see keynotes new or replaced concrete paving new pour-in-place rubberized surface


7 Control Joint

scale: 1" = 1'-0"

CL269647 by Landscape Structures, quote #104668-1-11. Contact Scott Anderson. phone: 818-735-3838 email: scott@recwest.com see 104668-1-11 and 104668-1-11F

Full bucket seat by Landscape Structures, quote #104668-1-11. Contact Scott Anderson.

phone: 818-735-3838 email: scott@recwest.com

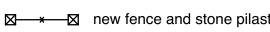

Playground

anyon

oldwater

Issue Date

12/22/2017 Plan Check

1 01/12/2018 Addendum 1

STUDIO

BRANDED ARCHITECTURE

3008 LINCOLN BLVD SANTA MONICA, CA 90405 T: 310.664.0651

MARCHSTUDIO.COM